


LEGEND

- PROPERTY LINE
- TRAVELED WAY
- ABUTTERS LINE
- 3 ROD ROAD
- 4 ROD ROAD
- CHAIN LINK FENCE
- IRON PIPE FOUND
- 5/8\" REBAR PLS #31
- CAPPED PIN FOUND
- IRON REBAR
- UTILITY POLE
- ANGLE POINT

SURVEYOR NOTES

- For details of burial plots see excel spreadsheet entitled, "Cemetery Records May 2018 BP Gould".
- Old section of burial lots, (Row E1 to Row F), based on location of driveways, headstone location, and assumption of 20' x 10' lots. No original monuments or plan found for this area. All lots based on as built conditions.
- For revision to new section of lots see Plan entitled "Plan of Lots E1 to E8 Gould Cemetery", Prepared by K & K Land Surveyors, Inc., Verne D. Pinney, PLS 1132, not recorded. See this Plans notes for description.

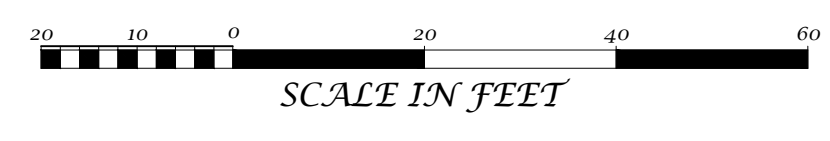

STATE OF MAINE
Somerset ss. Registry of Deeds
Received _____ 20____
at _____ h. _____ m. and Recorded
in Plan File _____ Page _____
Attest: _____
Register

SHEET TITLE:
Gould Cemetery Plan

SITE LOCATION:
Intersection of ME - 8 and Sand Hill Road

SCALE: 1" = 20'
DATE: September 1, 2018

RECORD OWNER:
**Inhabitants of the
Town of Smithfield**

ADDRESS:
P.O. BOX 67
Smithfield, Maine 04978

PLAN PREPARED BY:
Boynnton & Pickett L.L.C.
PROFESSIONAL LAND SURVEYOR
"When you want Professional Work, On Time and Affordable!"
922 East River Road, Scarborough, Maine 04976
Phone: (207) 424-0016 Cell: 207-988-7517
Email: wboynnton@aol.com
www.BoynntonPickett.com

Job #: TOWNSMITHCEM6.19.2018

