
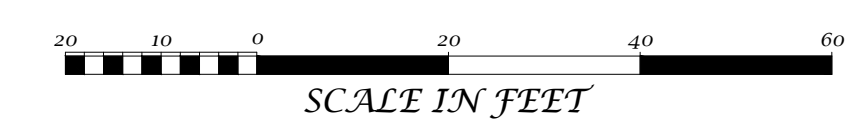


LEGEND

- PROPERTY LINE
- TRAVELED WAY
- ADJUTERS LINE
- 3' ROD ROAD
- 4' ROD ROAD
- CHAIN LINK FENCE

- SURVEYOR NOTES**
- 1.) For details of burial plots see excel spreadsheet entitled, "Cemetery Records May 2018 BP Village".
 - 2.) Old section of burial lots, based on location of driveways, headstone location, and assumption of 20' x 10' lots. No original monuments or plan found for this area. All lots based on as built conditions.
 - 3.) New section of burial lots, (Lot 125 to Lot 180), based on plan entitled "Standard Boundary Survey Plan of Cemetery Lots", Village Cemetery 1991 Annex, Town of Smithfield, Mt. Tom Road, Smithfield, ME, dated October 1998, prepared by J & K Land Surveyor Inc., Verne Pimney, PLS 1132, and recorded in the Kennebec Registry of Deeds, Plan File 98, Page 68. Notes make mention that lots 138, 140, 141, 146, 147, 152, 153, and 158 contain 120 sq. ft. (10' x 12') and are limited to three casket burials. All other numbered lots contain 200 sq. ft. (10' x 20') and are limited to five caskets burials.
 - 4.) For revision of new section of burial lots, see plan entitled, "Amendment to Plan of Cemetery Lots, Village Cemetery, 1991 Annex, Town of Smithfield", Mt. Tom Road, Smithfield, ME, prepared by J & K Land Surveyors Inc., Verne Pimney, PLS 1132, dated April 2004, and Recorded in the Somerset Registry of Deeds, Plan File 2004, Page 36.

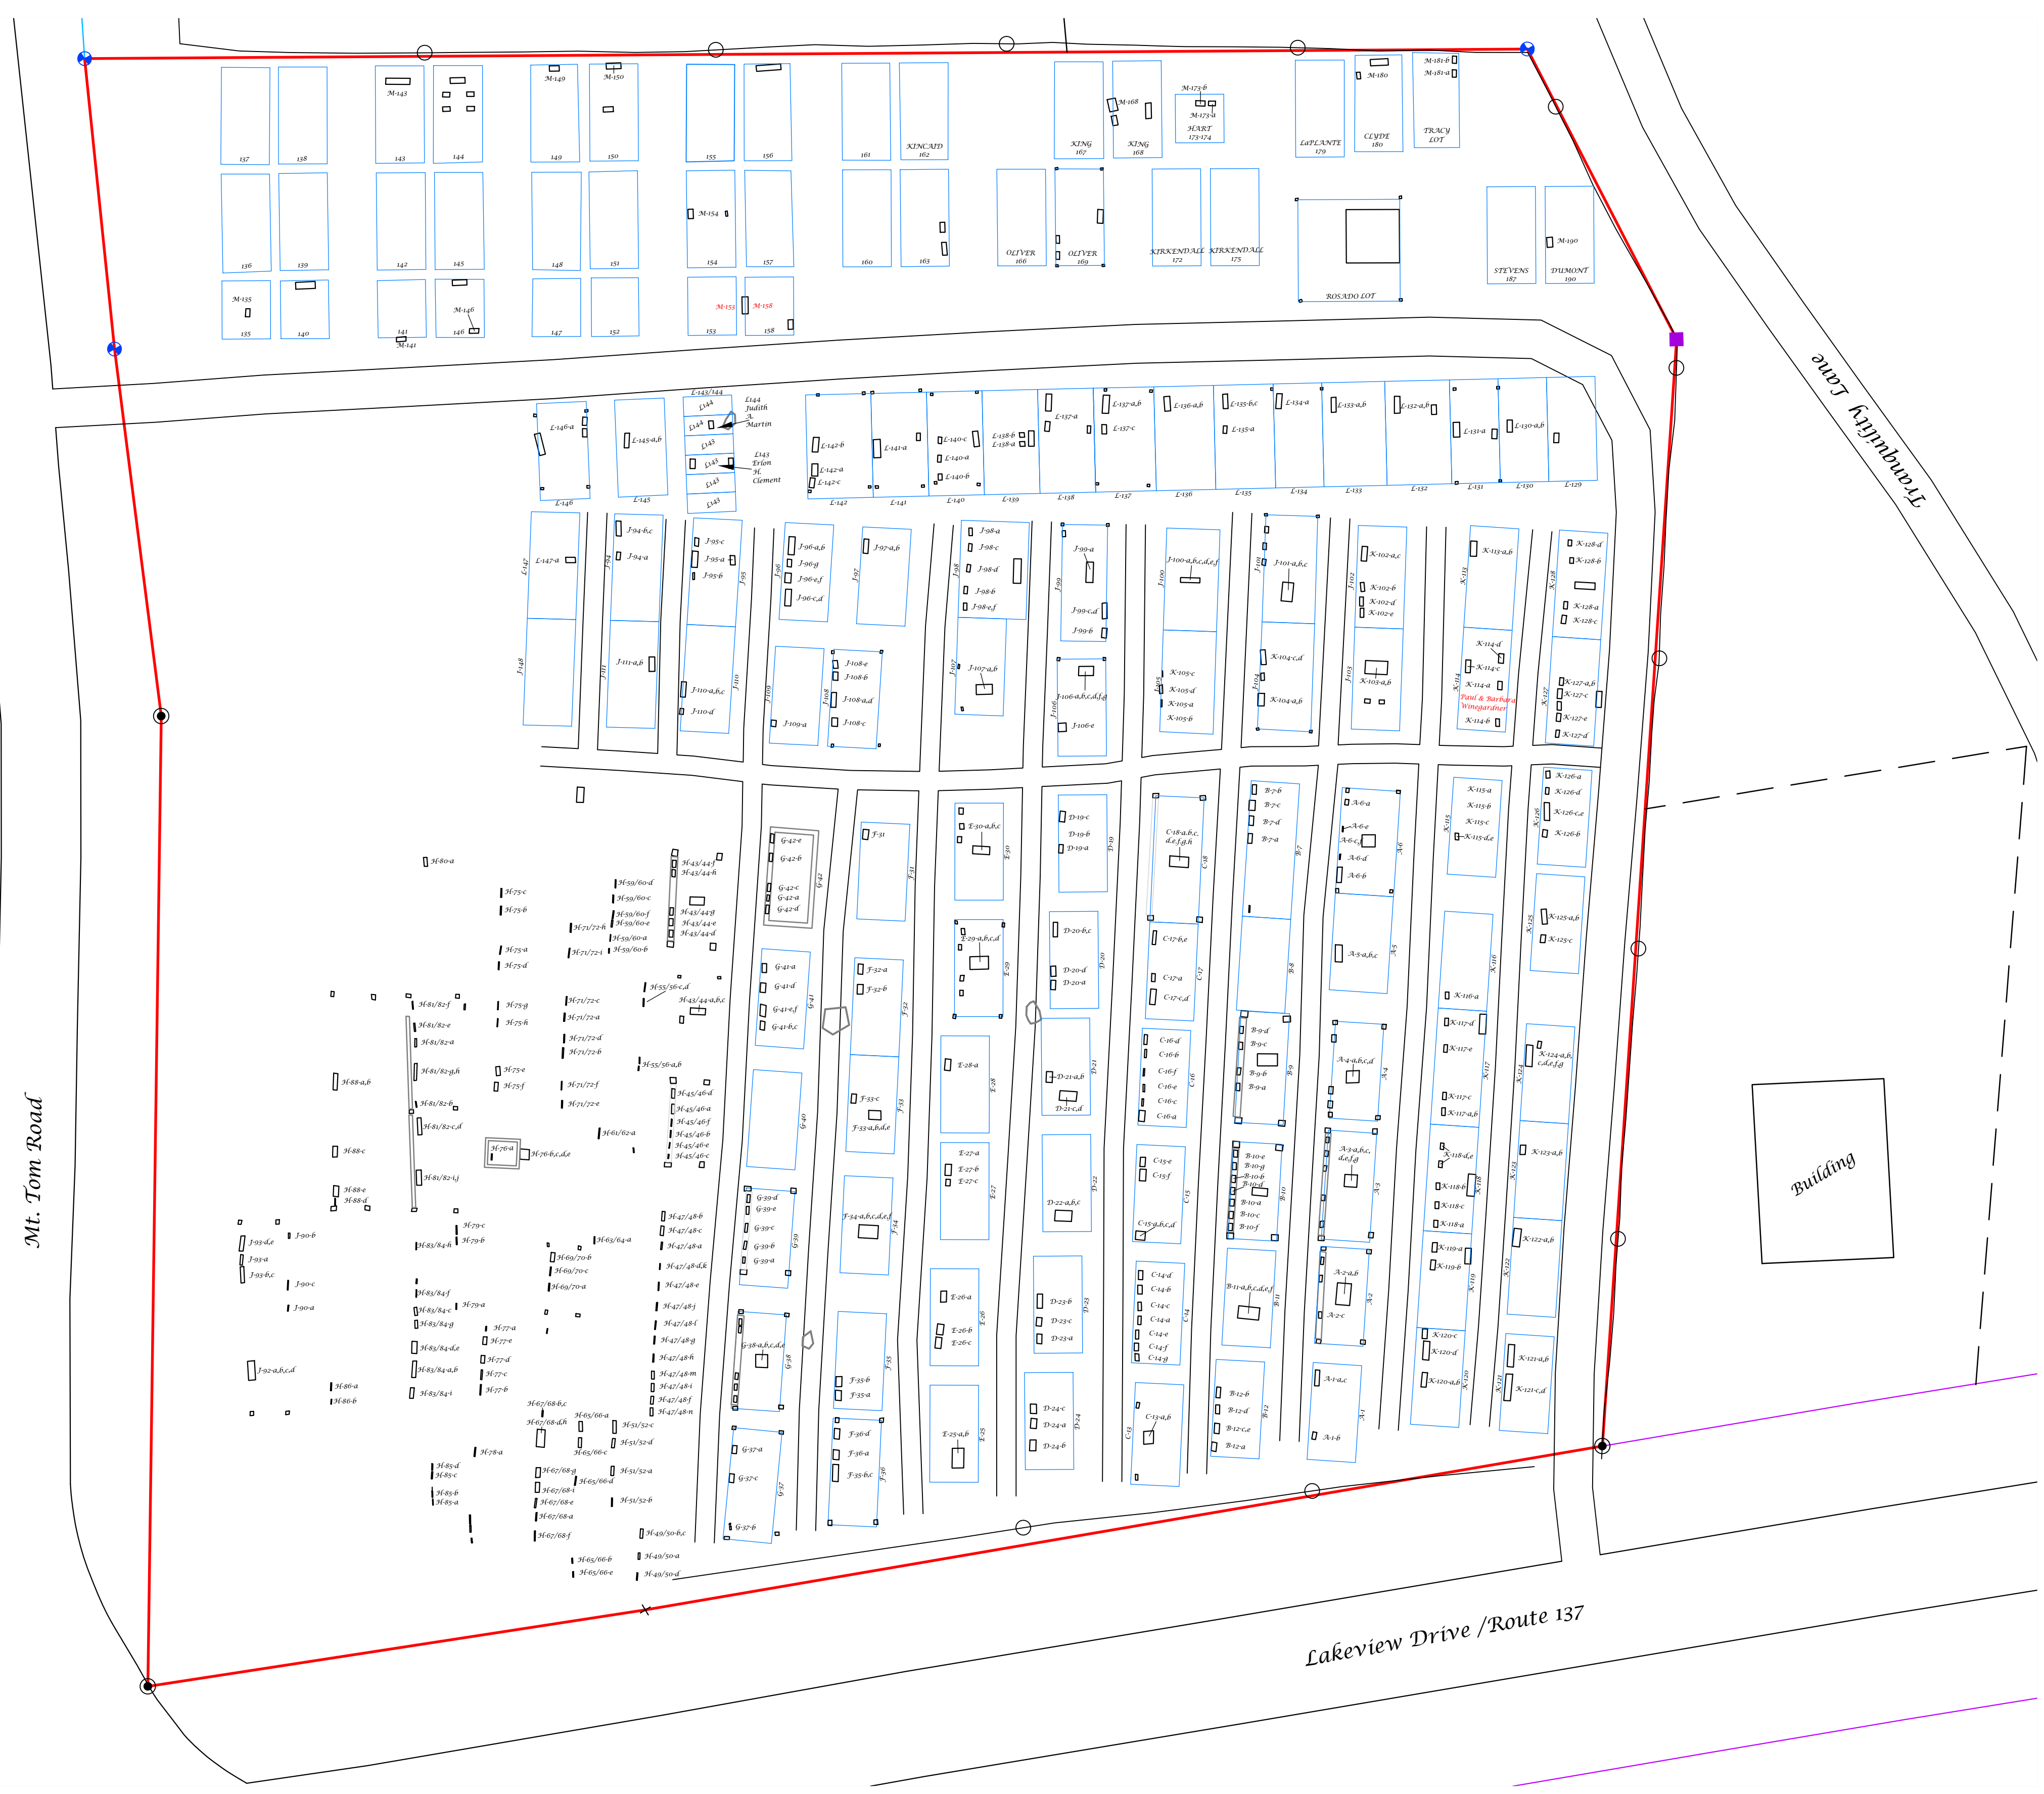

STATE OF MAINE
Somerset ss. Registry of Deeds
Received _____ at _____
_____ M., and Recorded
_____ in Plan File _____
_____ Page _____
Attest: _____
Register

SHEET TITLE:
Cemetery Plan- Village

SITE LOCATION:
Intersection of Mt. Tom Road & Lakeview Drive

SCALE: 1" = 20'

DATE: September 1, 2018

RECORD OWNER:
**Inhabitants of the
Town of Smithfield**

ADDRESS:
P.O. BOX 67
Smithfield, Maine 04978

PLAN PREPARED BY:
Boynton & Pickett L.L.C.
PROFESSIONAL LAND SURVEYOR
When you want Professional Work, on Time and Affordable!

922 East River Road, Skowhegan, Maine 04976
Phone: (207) 474-0000 Cell: 207-539-7517
Email: info@boyntonpickett.com
www.boyntonpickett.com

